

SECTION 00 91 12

ADDENDUM NUMBER 3



PARTICULARS

- 1.01 DATE: JUNE 4, 2021**
- 1.02 PROJECT: JOSEPH F. DRAKE MEMORIAL LIBRARY REROOFING**
- 1.03 PROJECT NUMBER: B. C. NO. 2020697**
- 1.04 PSCA NUMBER: 001P**
- 1.05 OWNER: ALABAMA A&M UNIVERSITY**
- 1.06 ARCHITECT: NOLA | VAN PEURSEM ARCHITECTS, PC**

TO PROSPECTIVE BIDDERS


- 2.01 THIS ADDENDUM FORMS A PART OF THE CONTRACT DOCUMENTS AND MODIFIES THE BIDDING DOCUMENTS DATED MAY 12, 2021, WITH AMENDMENTS AND ADDITIONS NOTED BELOW.**
- 2.02 ACKNOWLEDGE RECEIPT OF THIS ADDENDUM IN THE SPACE PROVIDED IN THE PROPOSAL FORM. FAILURE TO DO SO MAY DISQUALIFY THE BIDDER.**
- 2.03 THIS ADDENDUM CONSISTS OF 6 PAGES.**

CHANGES TO THE PROJECT MANUAL – Not Used

CHANGES TO THE DRAWINGS


- 4.01 DRAWING A-2.0 – DETAILS 1-11:**
 - A. Detail 1/A2.0: Revise this detail per Attachment ADD3-REV.1/A2.0.
 - B. Detail 2/A2.0: Revise this detail per Attachment ADD3-REV.2/A2.0.
 - C. Detail 3/A2.0: Revise this detail per Attachment ADD3-REV.3/A2.0.
 - D. Detail 4/A2.0: Revise this detail per Attachment ADD3-REV.4/A2.0.
 - E. Detail 8/A2.0: Revise this detail per Attachment ADD3-REV.8/A2.0.

END OF ADDENDUM NUMBER 3


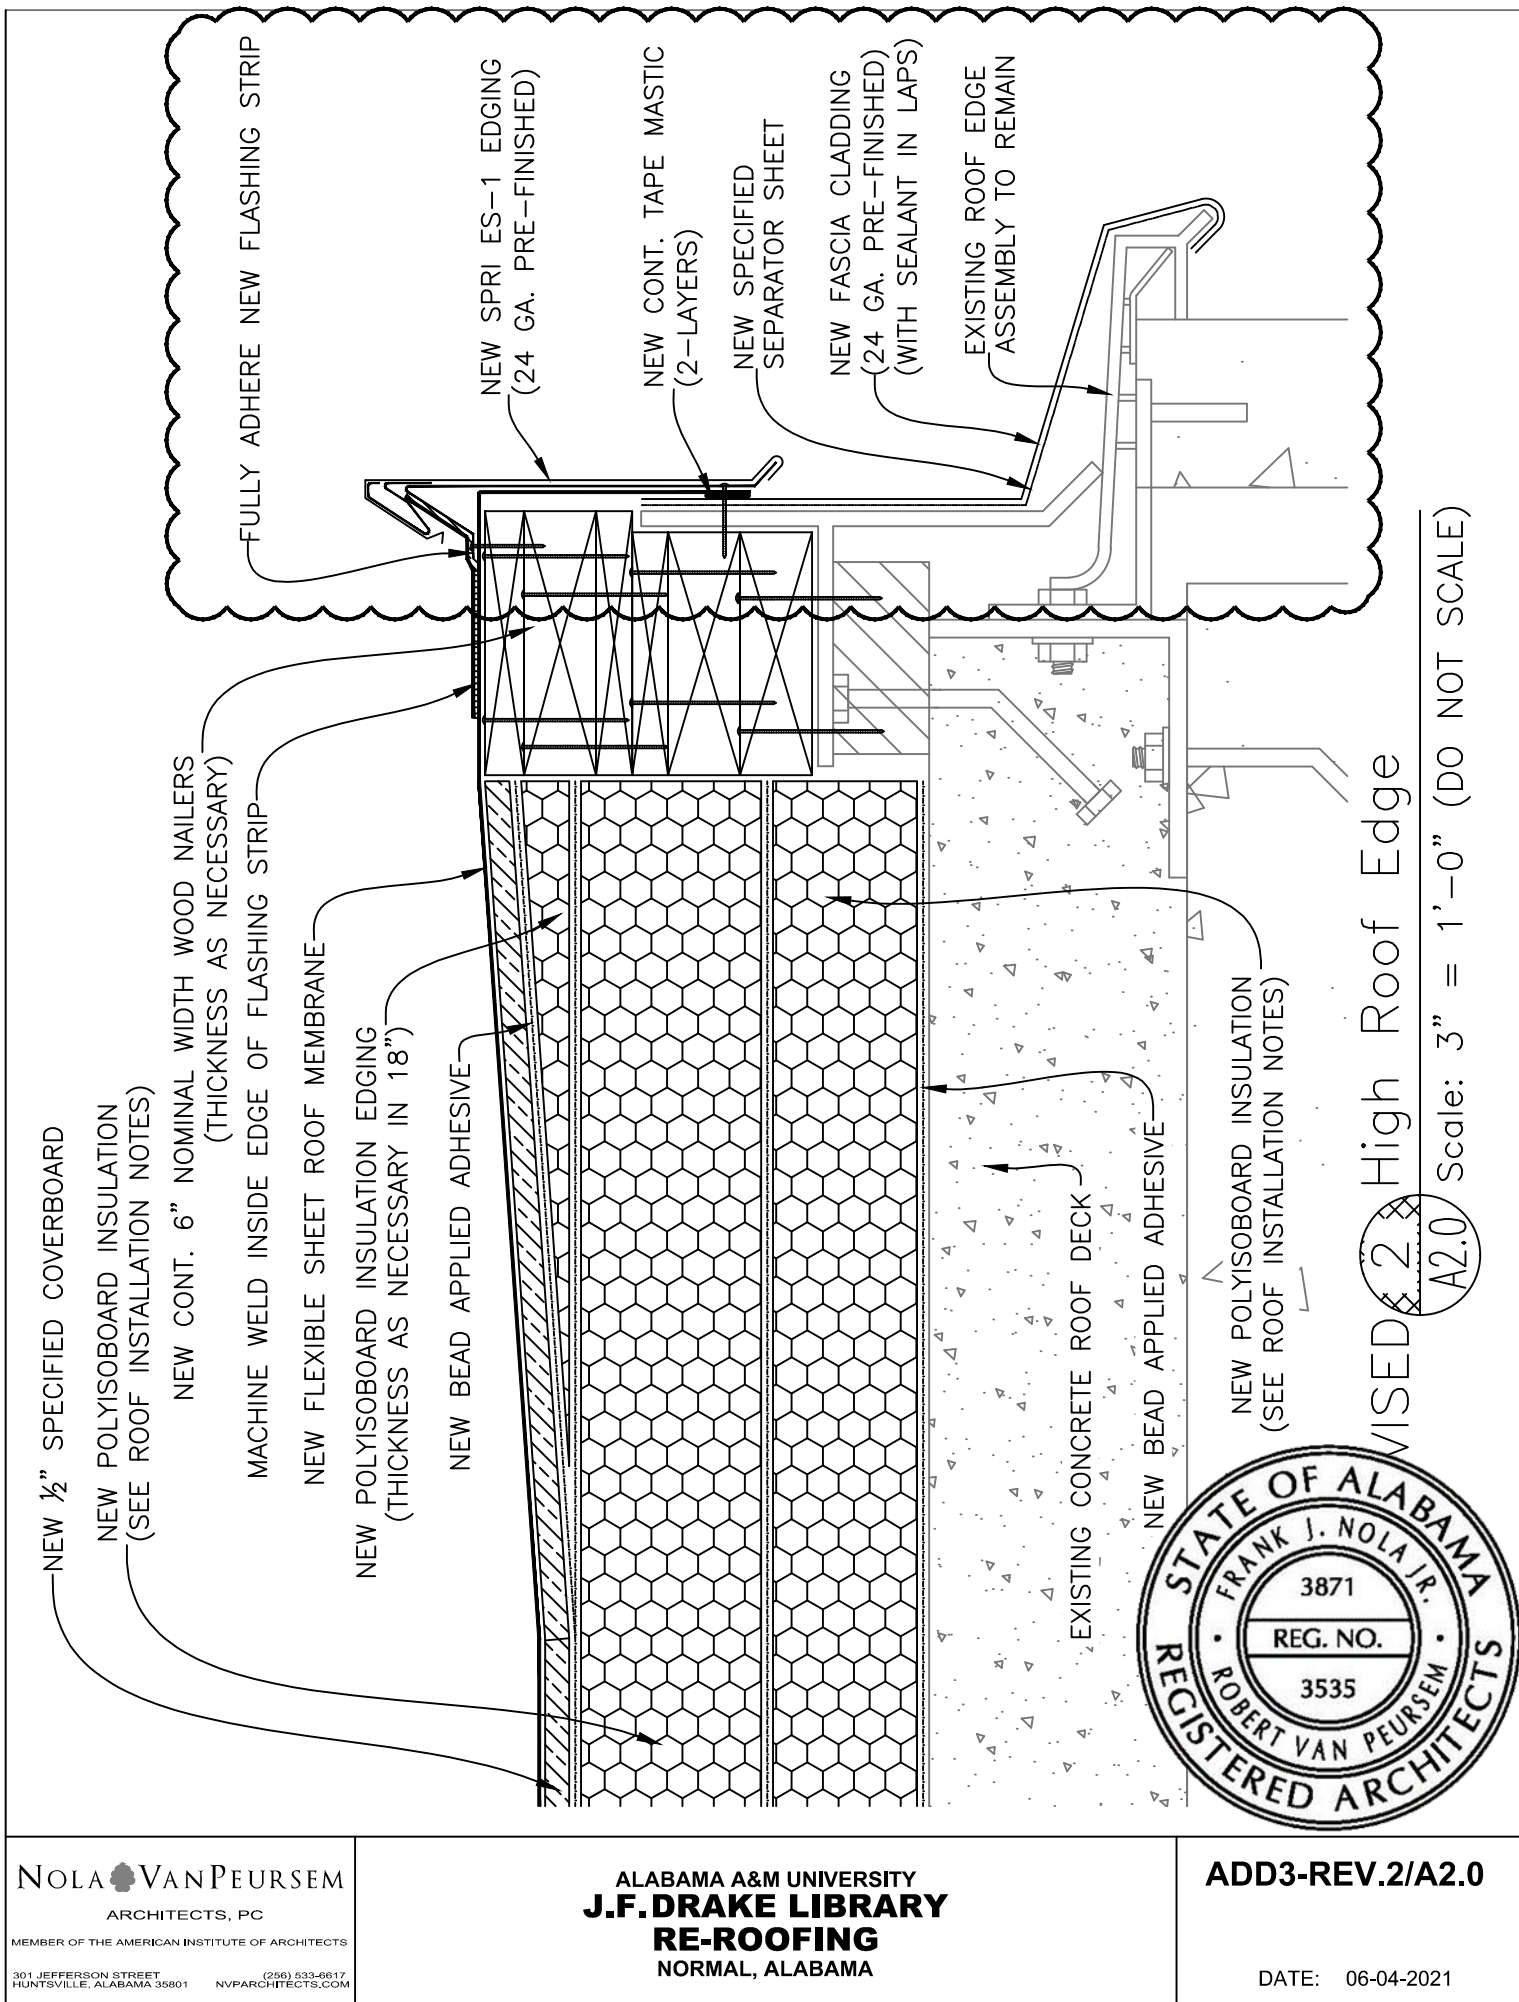


2x High Roof Edge


A2.0 Scale: 3" = 1'-0" (DO NOT SCALE)

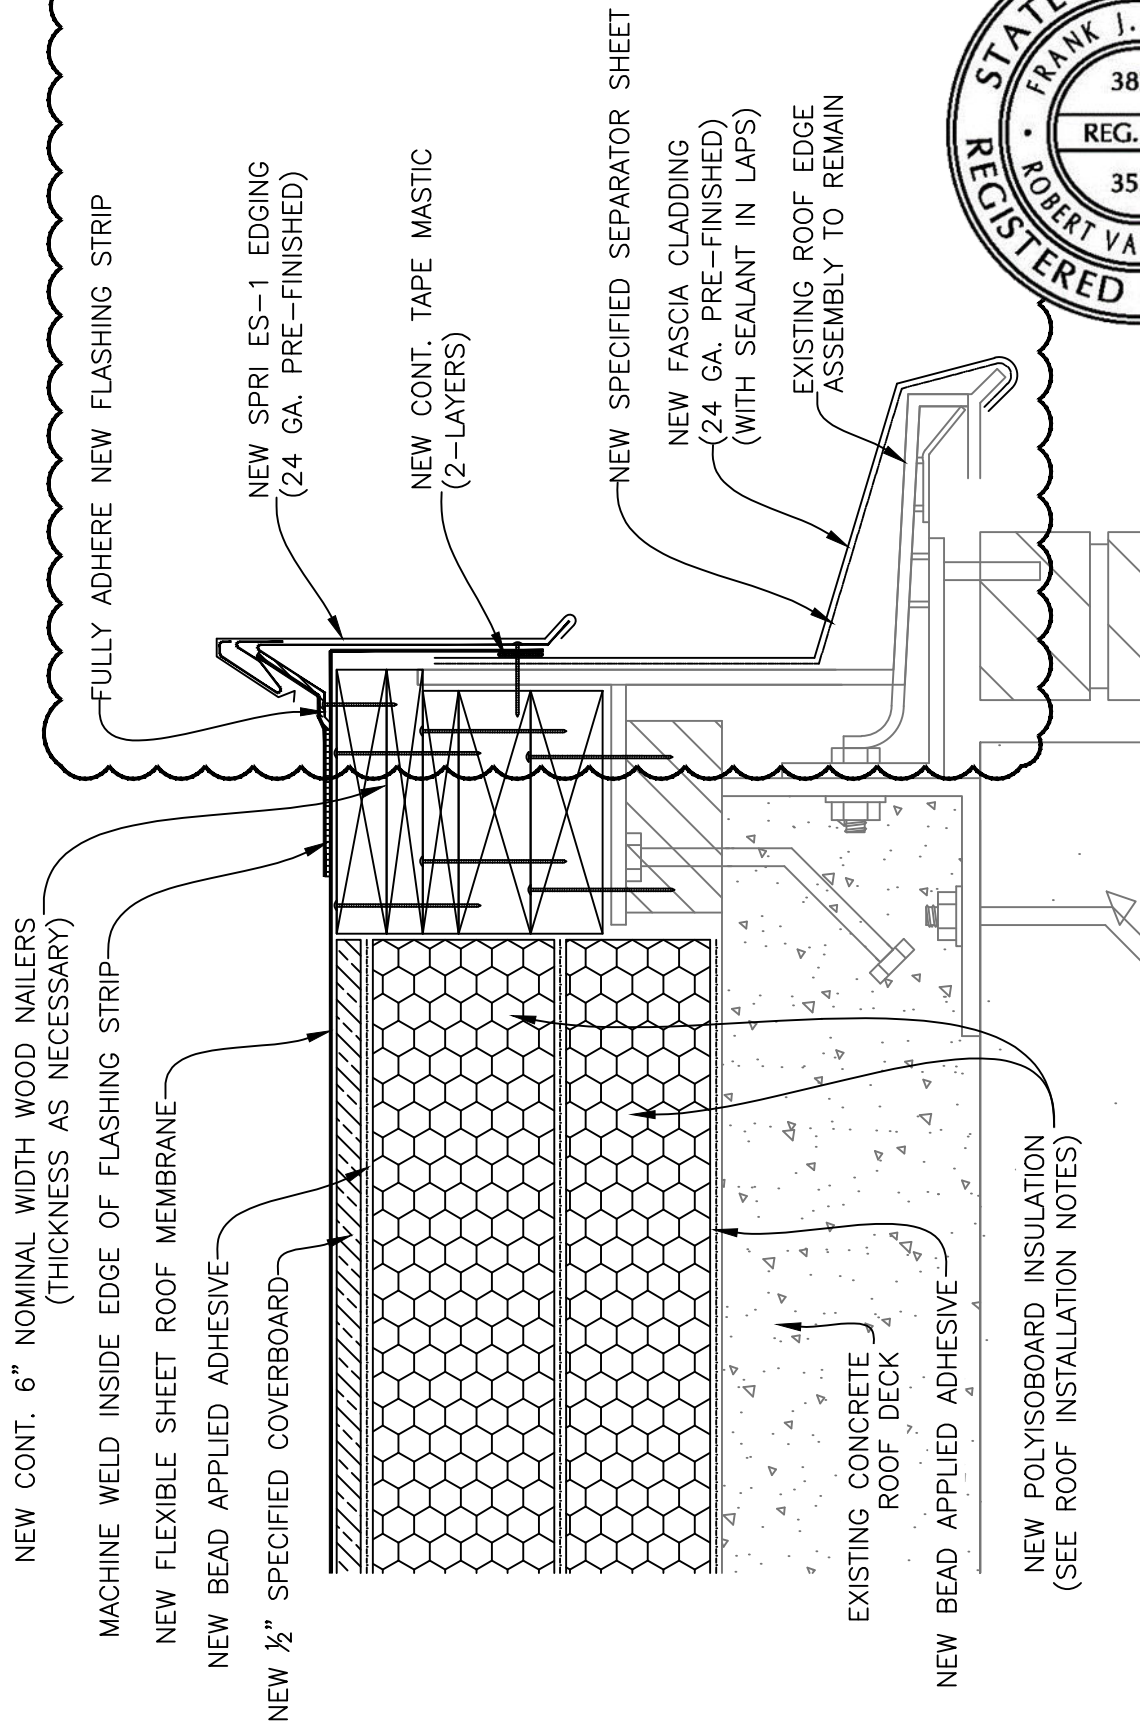

REVISED ~~3~~ ^{A2.0} High Roof Edge
Scale: 3" = 1'-0" (DO NOT SCALE)

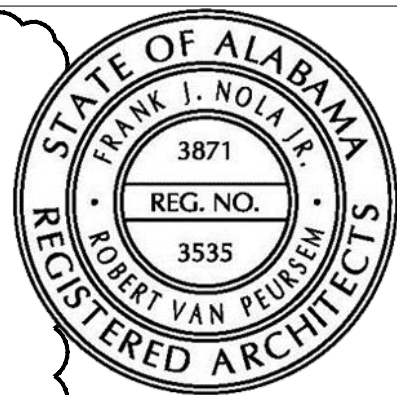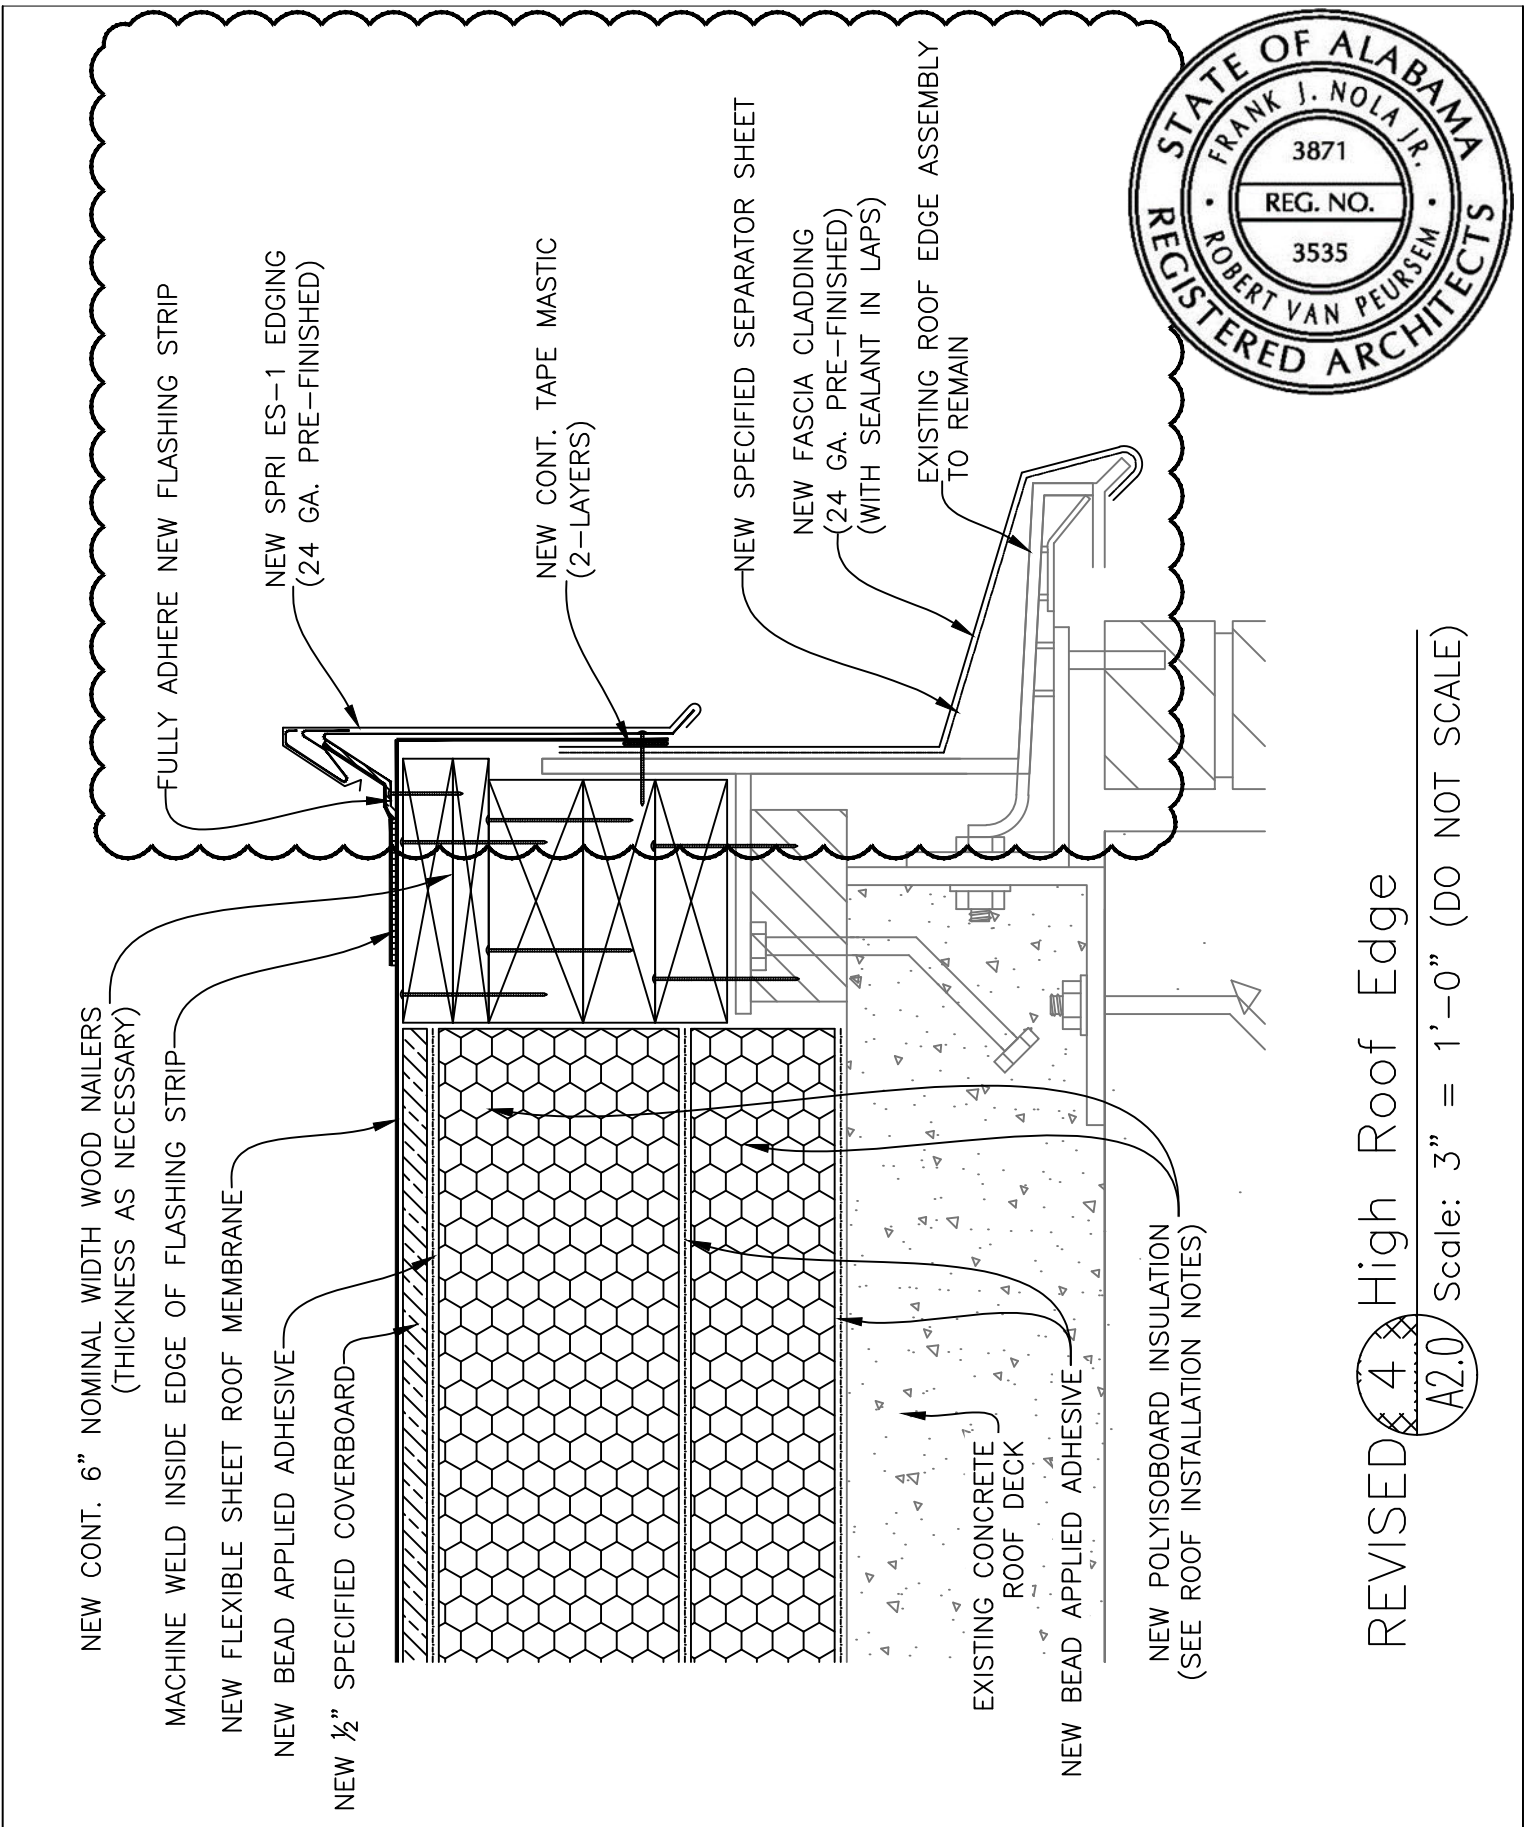

REVISED ~~4~~ ^{A2.0} High Roof Edge
 Scale: 3" = 1'-0" (DO NOT SCALE)

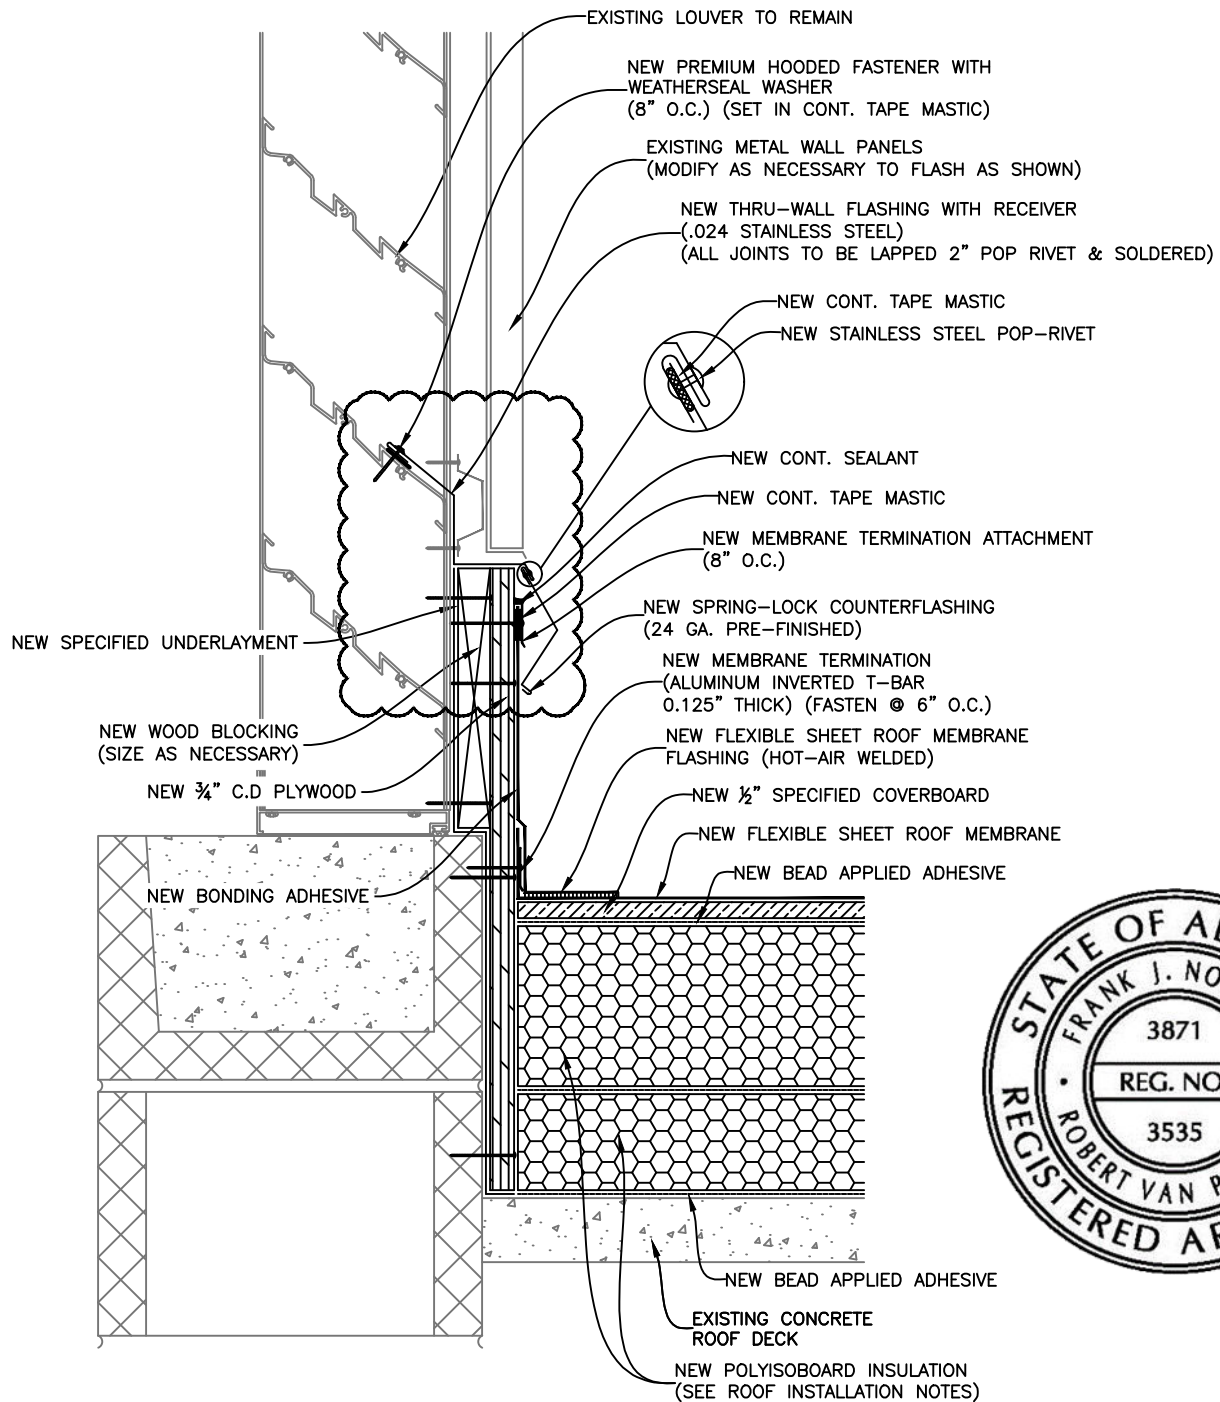

Base Flashing New Thru-Wall Flashing @
REVISED 8 Metal Panels Over Existing Louver

A2.0 Scale: Not To Scale

NOLA VANPEURSEM
ARCHITECTS, PC

MEMBER OF THE AMERICAN INSTITUTE OF ARCHITECTS

301 JEFFERSON STREET (256) 533-6617
HUNTSVILLE, ALABAMA 35801 NVPARCHITECTS.COM

ALABAMA A&M UNIVERSITY
J.F. DRAKE LIBRARY
RE-ROOFING
NORMAL, ALABAMA

ADD3-REV.8/A2.0

DATE: 06-04-2021